


3-18-14
MOD LAYOUT
VERIFICATION SURVEY

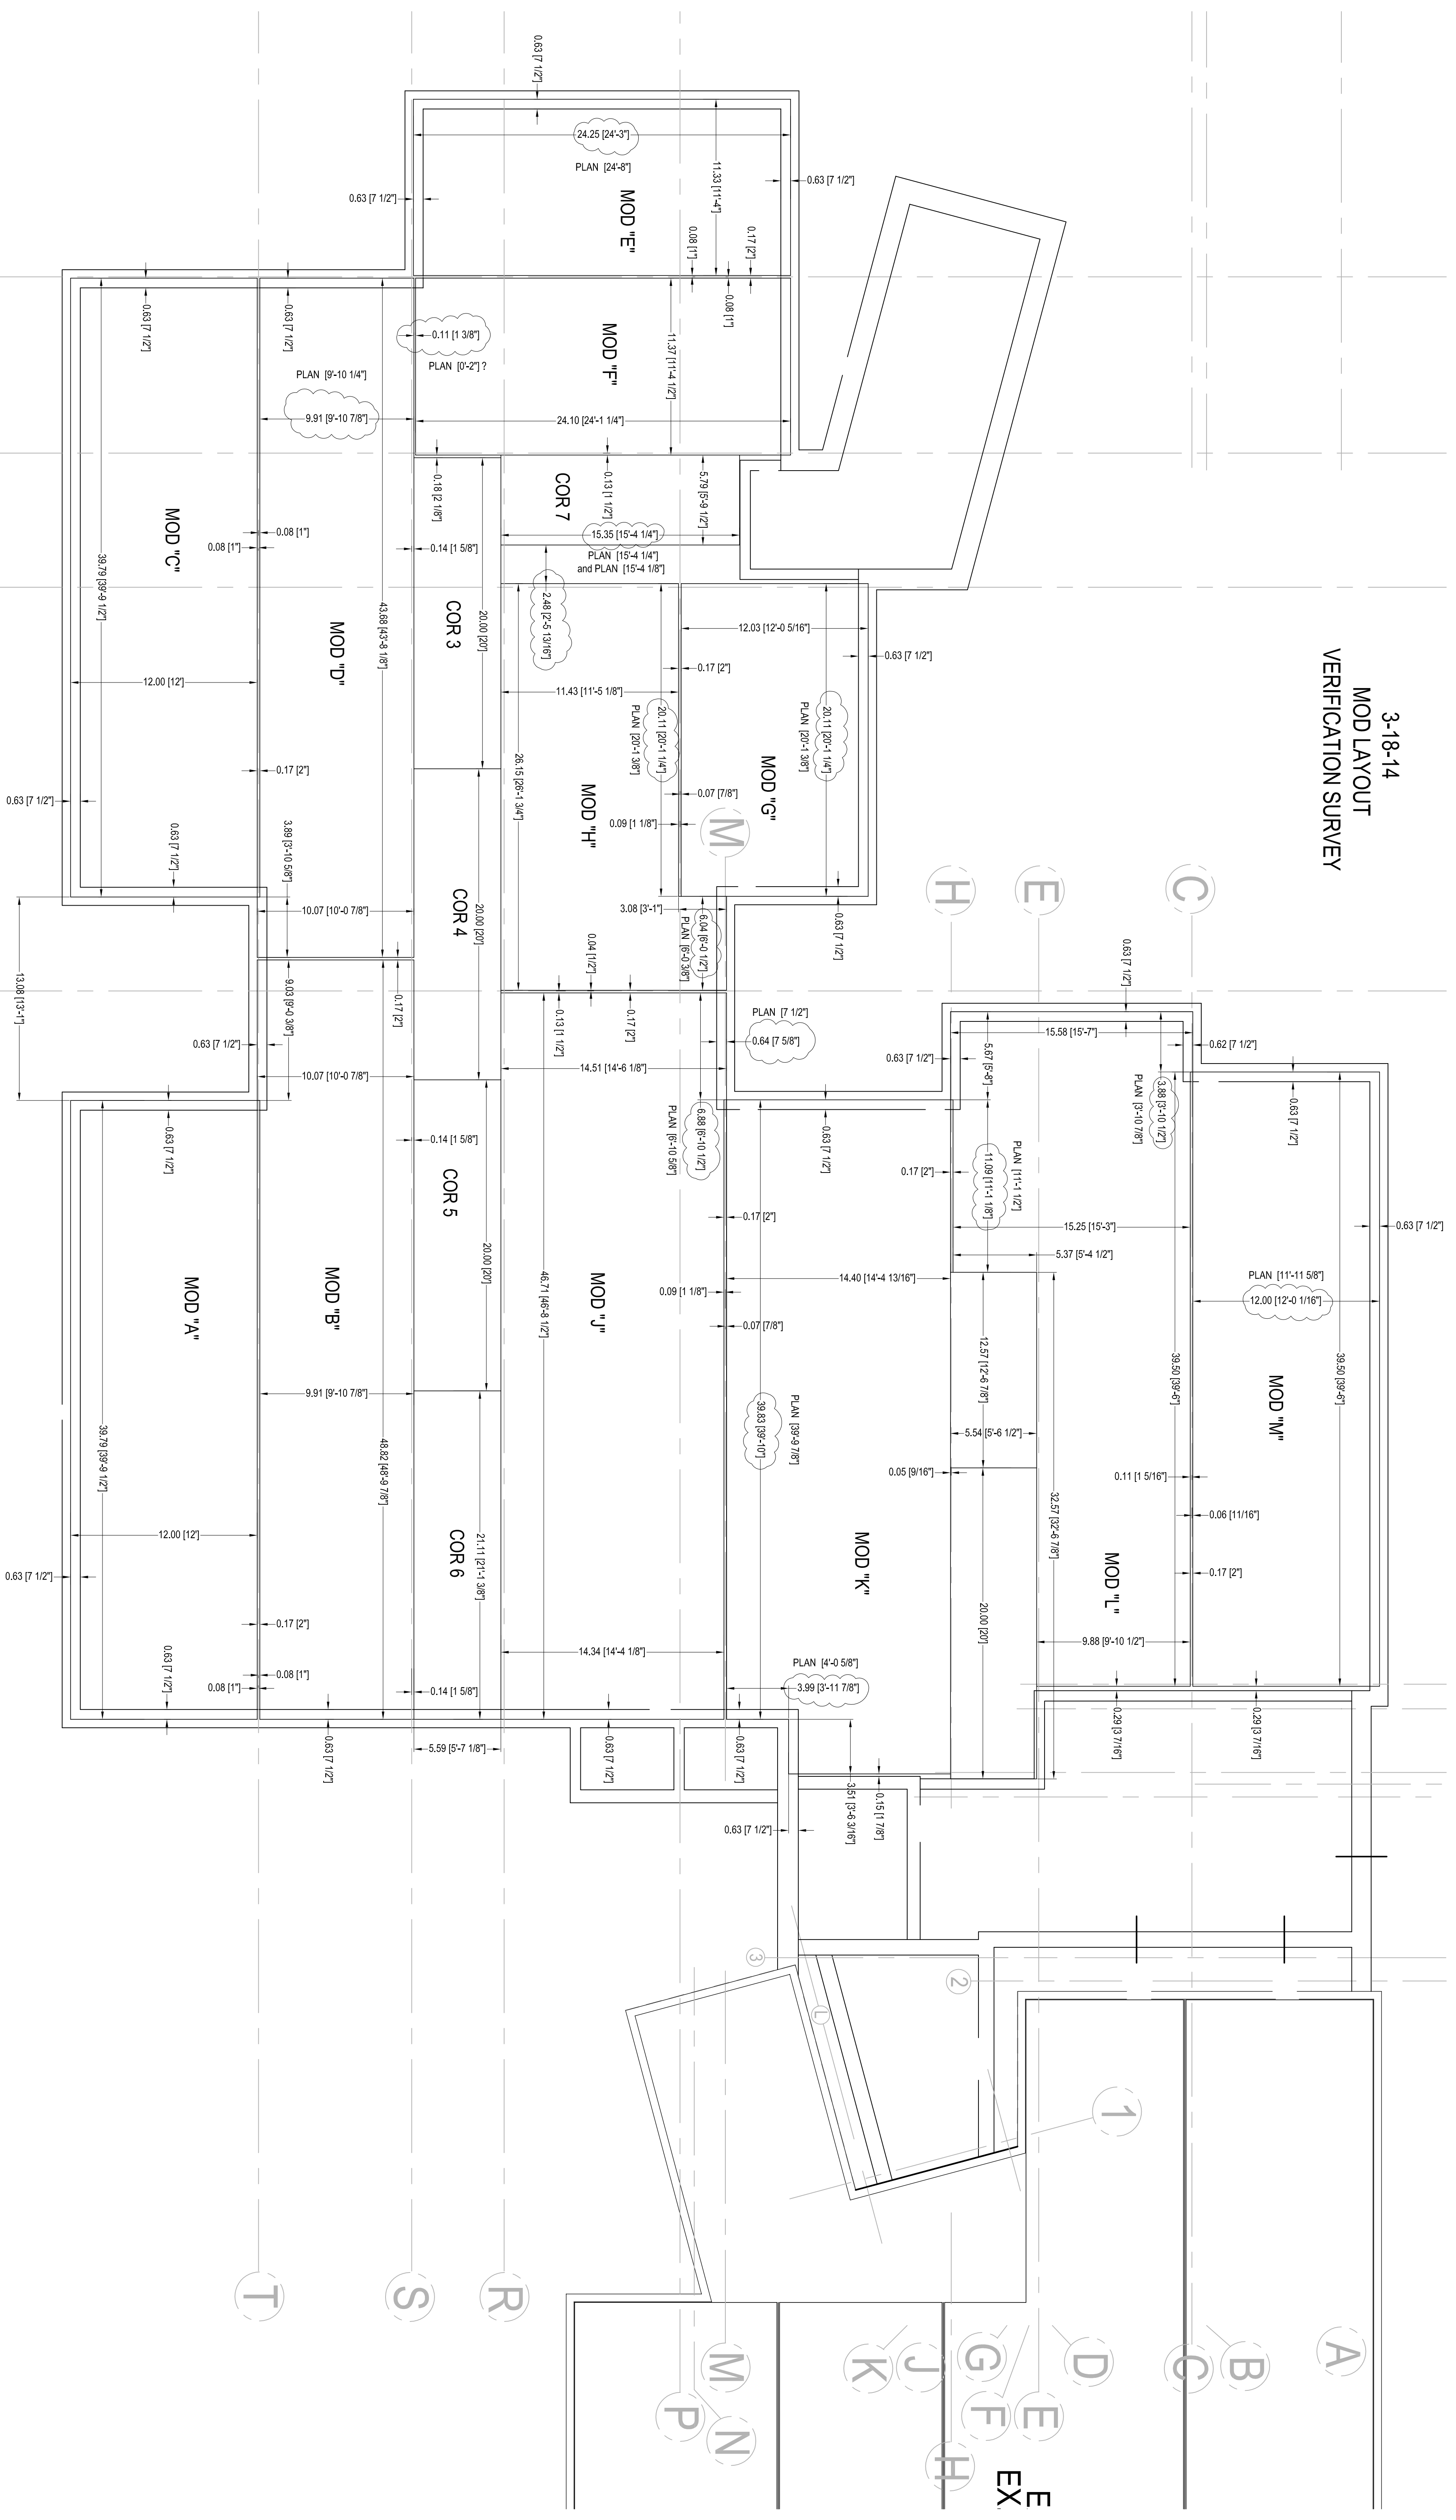

19

18

17

15

8

7

6

5

4

3

2

T

S

R

M
N
P

K
J
H

E
F
G
EX

D
C

B
A