WRS 08.13.15
CENTER OF PLATE AS-BUILTS

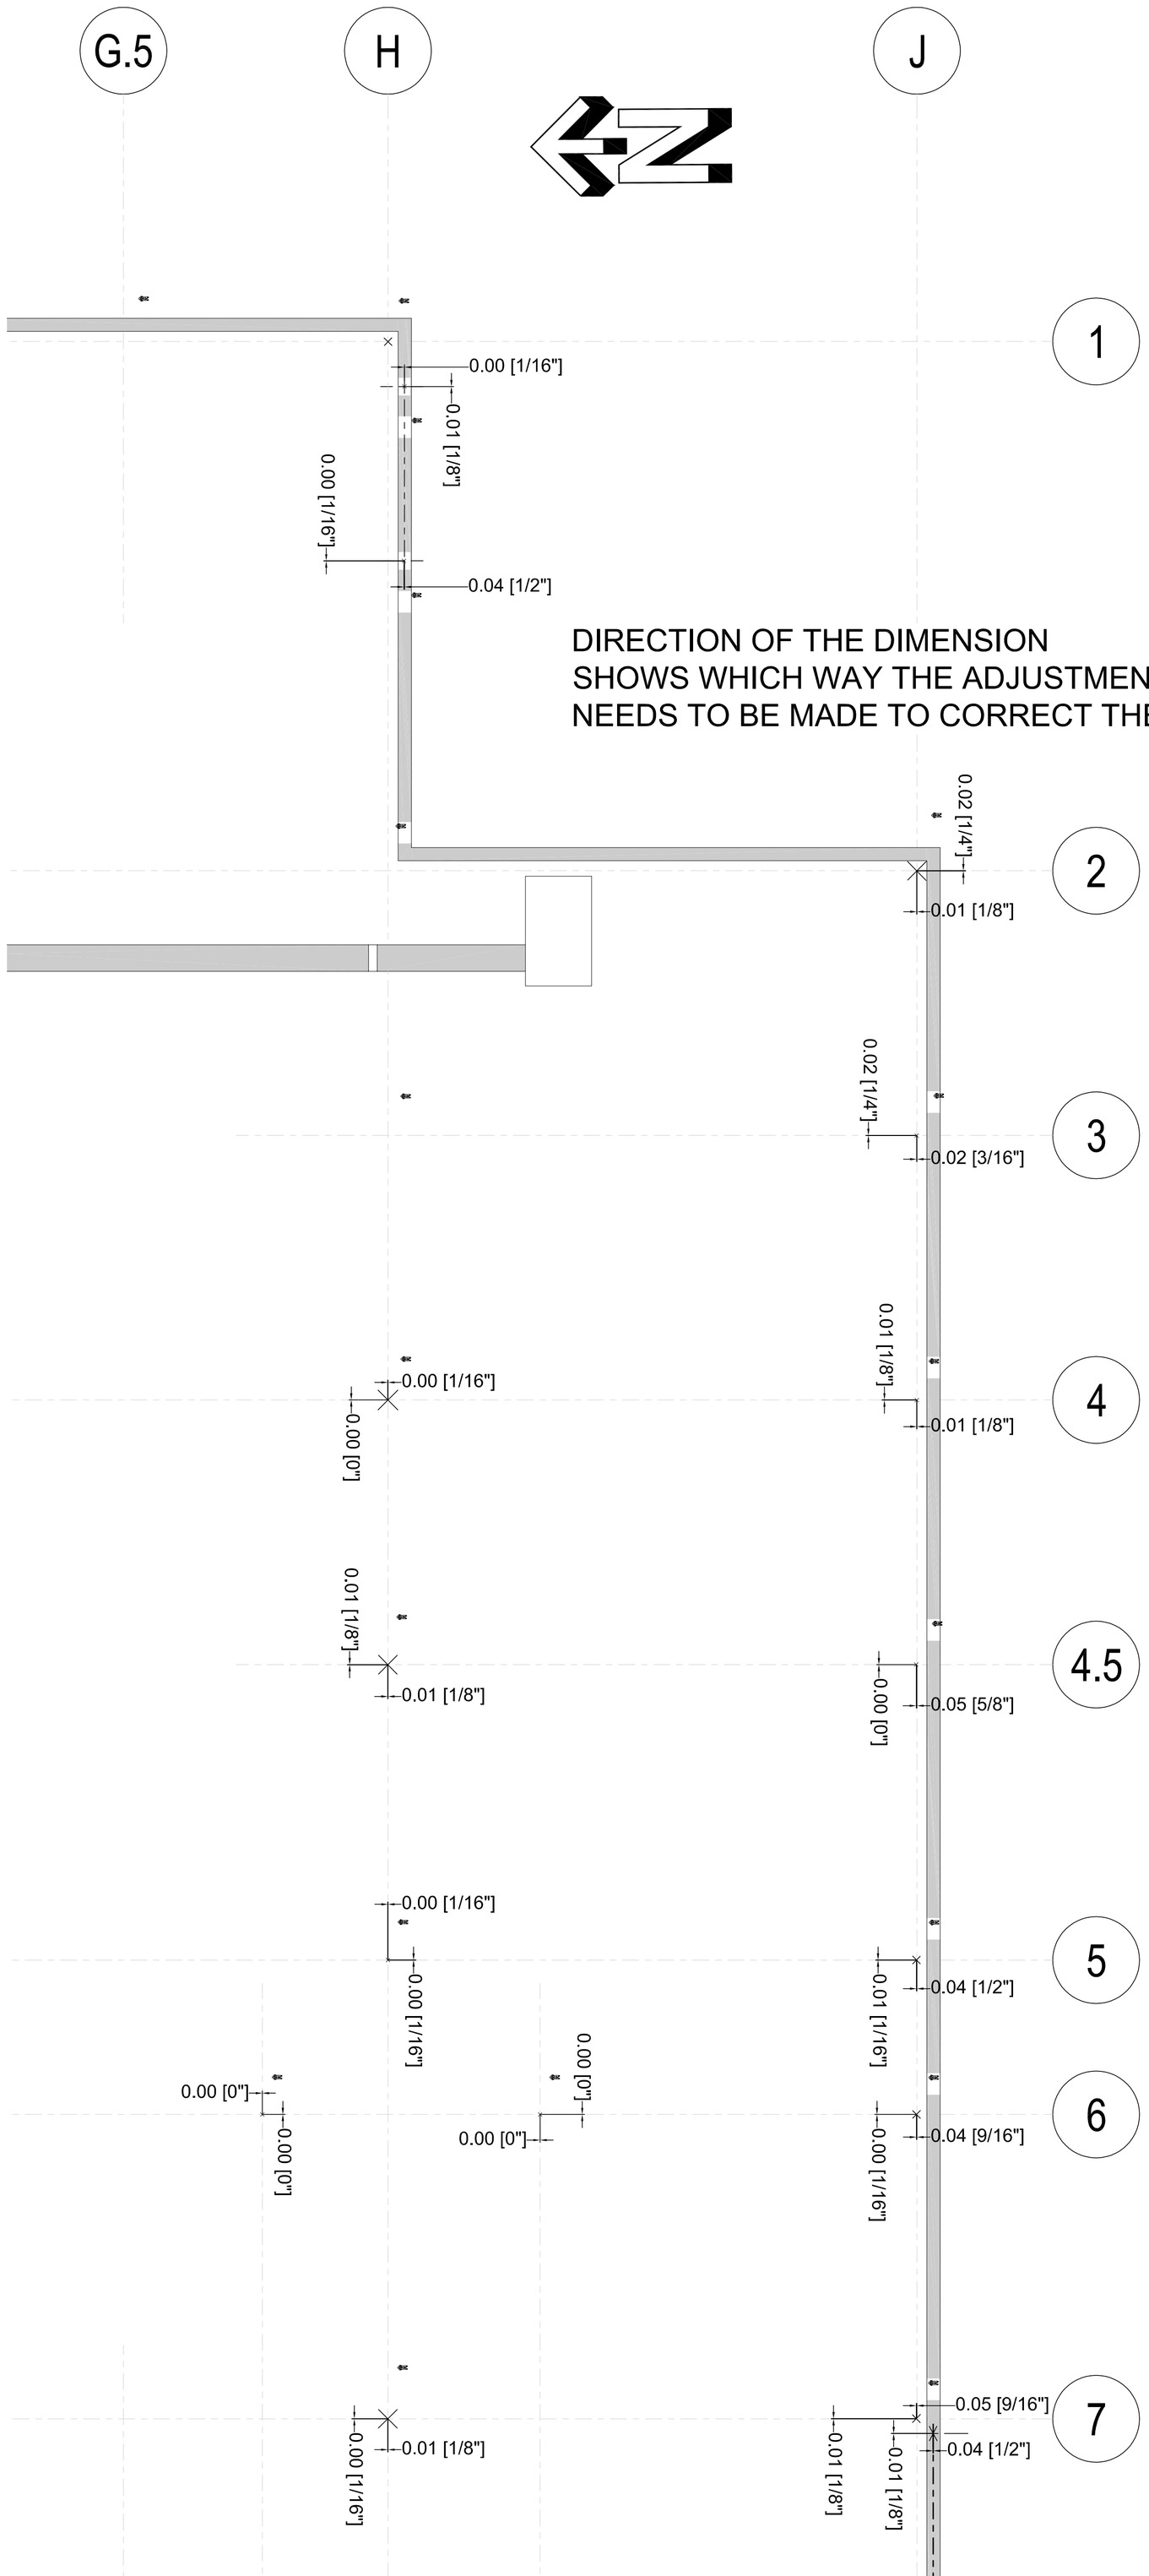

DIRECTION OF THE DIMENSION
SHOWS WHICH WAY THE ADJUSTMENT
NEEDS TO BE MADE TO CORRECT THE PATTERN.